



# Indiana Department of Environmental Management

## Office of Water Quality

### Wetlands Section

Publication Date:  
May 12, 2010

Closing Date:  
June 2, 2010

IDEM ID Number:  
2010-117-29-EMP-V

Corps of Engineers ID Number:  
LRL-2009-575-cmh

## PUBLIC NOTICE

### To all interested parties:

This letter shall serve as a formal notice of the receipt of an application for **Section 401 Water Quality Certification** by the Indiana Department of Environmental Management (IDEM). The purpose of the notice is to inform the public of active applications submitted for water quality certification under Section 401 of the Clean Water Act (33 U.S.C. § 1341) and to solicit comments and information on any impacts to water quality related to the proposed project. IDEM will evaluate whether the project complies with Indiana's water quality standards as set forth at 327 IAC 2.


- |                      |  |                  |  |
|----------------------|--|------------------|--|
| <b>1. Applicant:</b> | Mr. Ed Hunt<br>The Hunt Paving Company<br>2450 S. Tibbs Ave., PO Box 42517<br>Indianapolis, IN 46242 | <b>2. Agent:</b> | Ms. Becka Davidson<br>Professional Service Industries, Inc.<br>5362 W. 78 <sup>th</sup> Street<br>Indianapolis, IN 46268 |
|----------------------|--|------------------|--|
- 3. Project location:** SW 1/4 Section 6, Township 19 North, Range 5 East, Noblesville USGS Quad Map  
Violation is located S of Pleasant Street, E of 13<sup>th</sup> Street, and west of an unnamed tributary to Stony Creek, in Noblesville, Hamilton Co.
- 4. Affected waterbody:** emergent wetland
- 5. Project Description:** The applicant is applying for **after-the-fact** Section 401 Water Quality Certification for filling approximately 1.13 acres of a 2.14+ acre emergent wetland without IDEM authorization; unauthorized filling has been documented over several years. As mitigation for unauthorized impacts, the applicant has agreed to purchase 2.5 acres of emergent wetland mitigation credit from the Central Indiana Mitigation bank located in Henry County.

**Comment period:** Any person or entity who wishes to submit comments or information relevant to the aforementioned project may do so by the closing date noted above. Only comments or information related to water quality or potential impacts of the project on water quality can be considered by IDEM in the water quality certification review process.

**Public Hearing:** Any person may submit a written request that a public hearing be held to consider issues related to water quality in connection with the project detailed in this notice. The request for a hearing should be submitted within the comment period to be considered timely. The request should also state the reason for the public hearing as specifically as possible to assist IDEM in determining whether a public hearing is warranted.

**Questions?** Additional information may be obtained from Ms. Liz Pelloso, Project Manager, at 317-233-2482. Please address all correspondence to the project manager and reference the IDEM project identification number listed on this notice. Indicate if you wish to receive a copy of IDEM's final decision. Written comments and inquiries may be forwarded to -

Indiana Department of Environmental Management  
100 North Senate Avenue  
MC65-42 WQS IGCN 1255  
Indianapolis, Indiana 46204-2251  
FAX: 317/232-8406

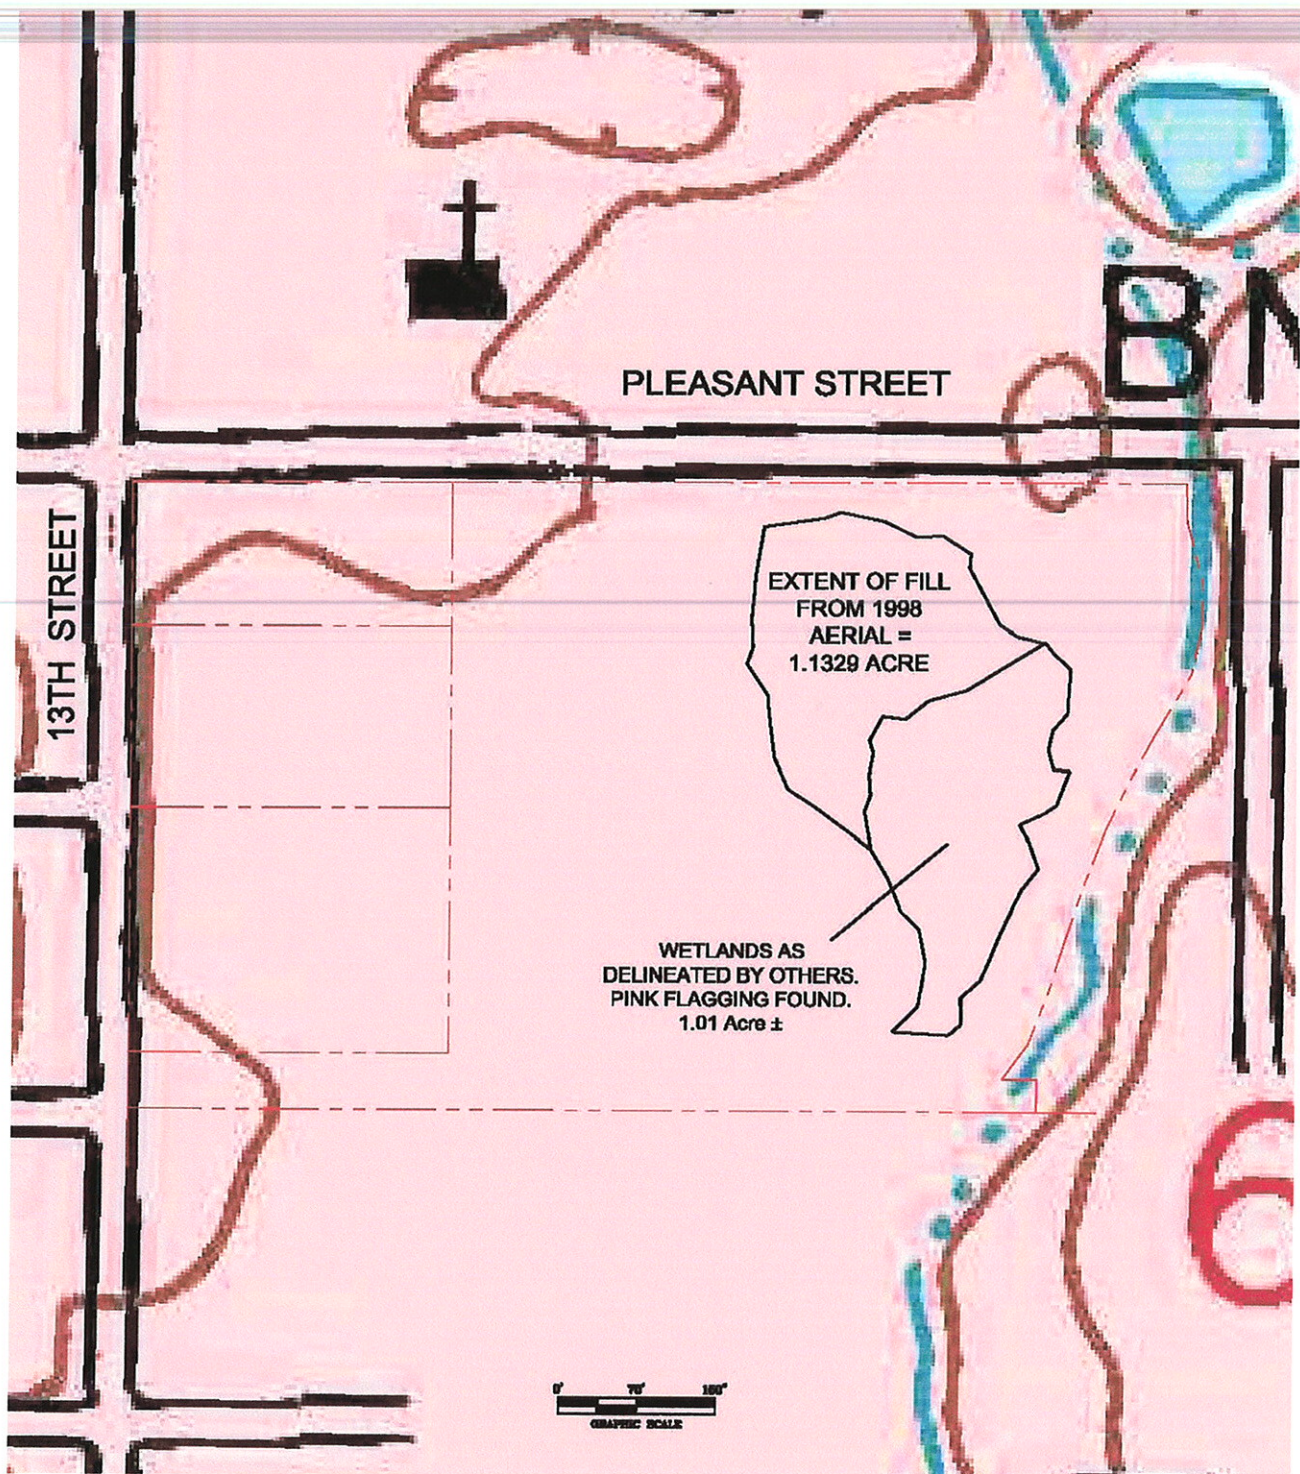

Source: U.S.G.S. Noblesville, IN (1998) and Riverwood, IND (1969, Photorevised 1988, Minor Revision 1994)



**psi** Information  
To Build On  
Engineering • Consulting • Testing

Professional Service Industries, Inc.

Project: Albright Wetland – Pleasant Street Properties  
Client: Riley, Bennett & Egloff, LLP  
Location: Noblesville, Hamilton County, IN  
Job No.: 0017333  
Date: March 2010  
Scale: Approx 1" = 180'

Figure 1  
Wetland Fill  
Map

5362 West 78th Street, Indianapolis, Indiana 46268

4-23-10



[illegible]

JFNew# 920813INX



708 Roosevelt Road, Walkerton, IN 46574  
Phone 574-586-3400 / Fax 574-586-3446  
[www.jfnew.com](http://www.jfnew.com)